
# LOTIS WELLINGTON

WELLINGTON, FL SITE AMENITIES PLAN ARCHITECTURAL REVIEW BOARD

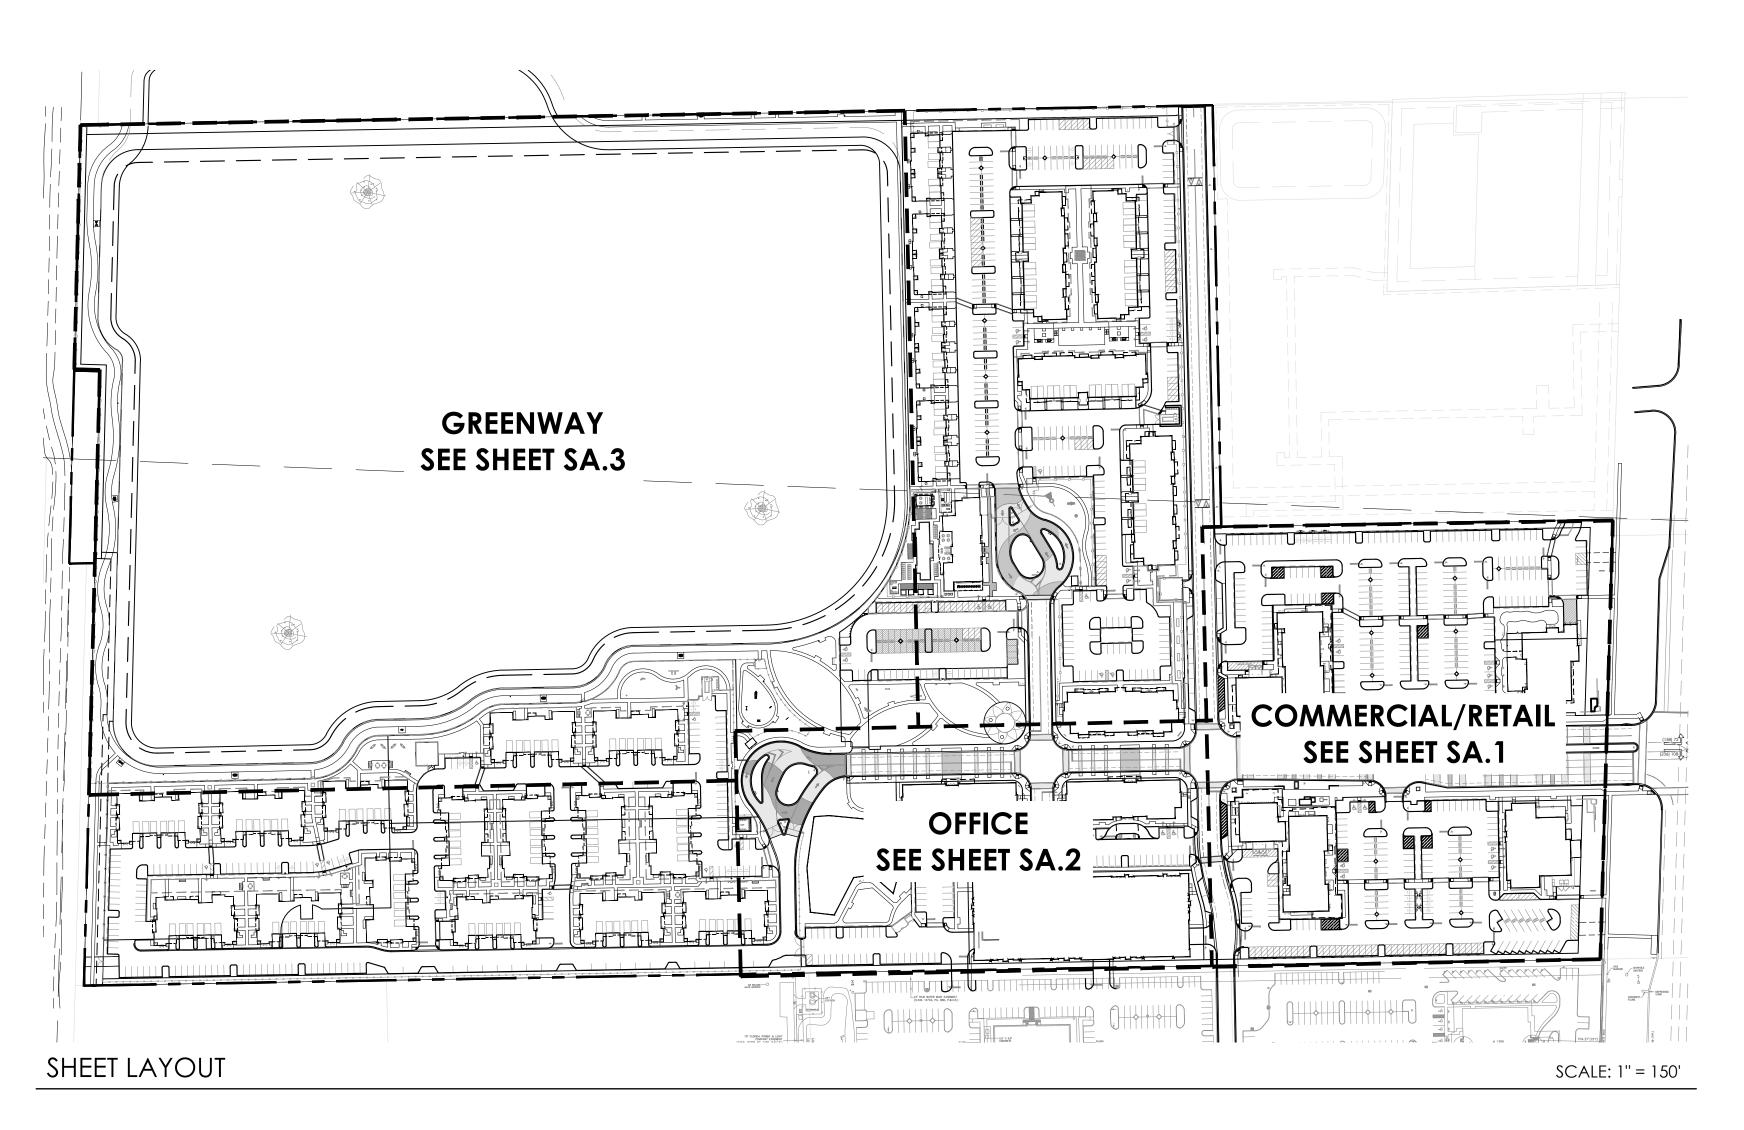

### SHEET INDEX

JILLI II VDLA		
SHEET	DESCRIPTION	
SA.0	SITE AMENITIES COVER	
SA.1	SITE AMENITIES PLAN (RETAIL/COMMERCIAL	
SA.2	SITE AMENITIES PLAN (OFFICE)	
SA.3	SITE AMENITIES PLAN (GREENWAY)	
SA.4	SITE AMENITIES DETAILS	
SA.5	SITE AMENITIES DETAILS	
SA.6	SITE AMENITIES DETAILS	
SA.7	SITE AMENITIES DETAILS	
A2.01-SHD	SITE AMENITIES DETAILS	
A2.01-STS	SITE AMENITIES DETAILS	

07/17/2023 - RESUBMITTAL 10/02/2023 - REVISION


LOTIS WELLIN Wellington,

Drawn By: 1076 Drawing #: 01/31/2022

> SITE AMENITIES COVER PAGE

SHEET # SA.O

NOTE: ALL REVISED OR ADDED ITEMS HAVE BEEN CLOUDED FOR EASE OF REFERENCE.

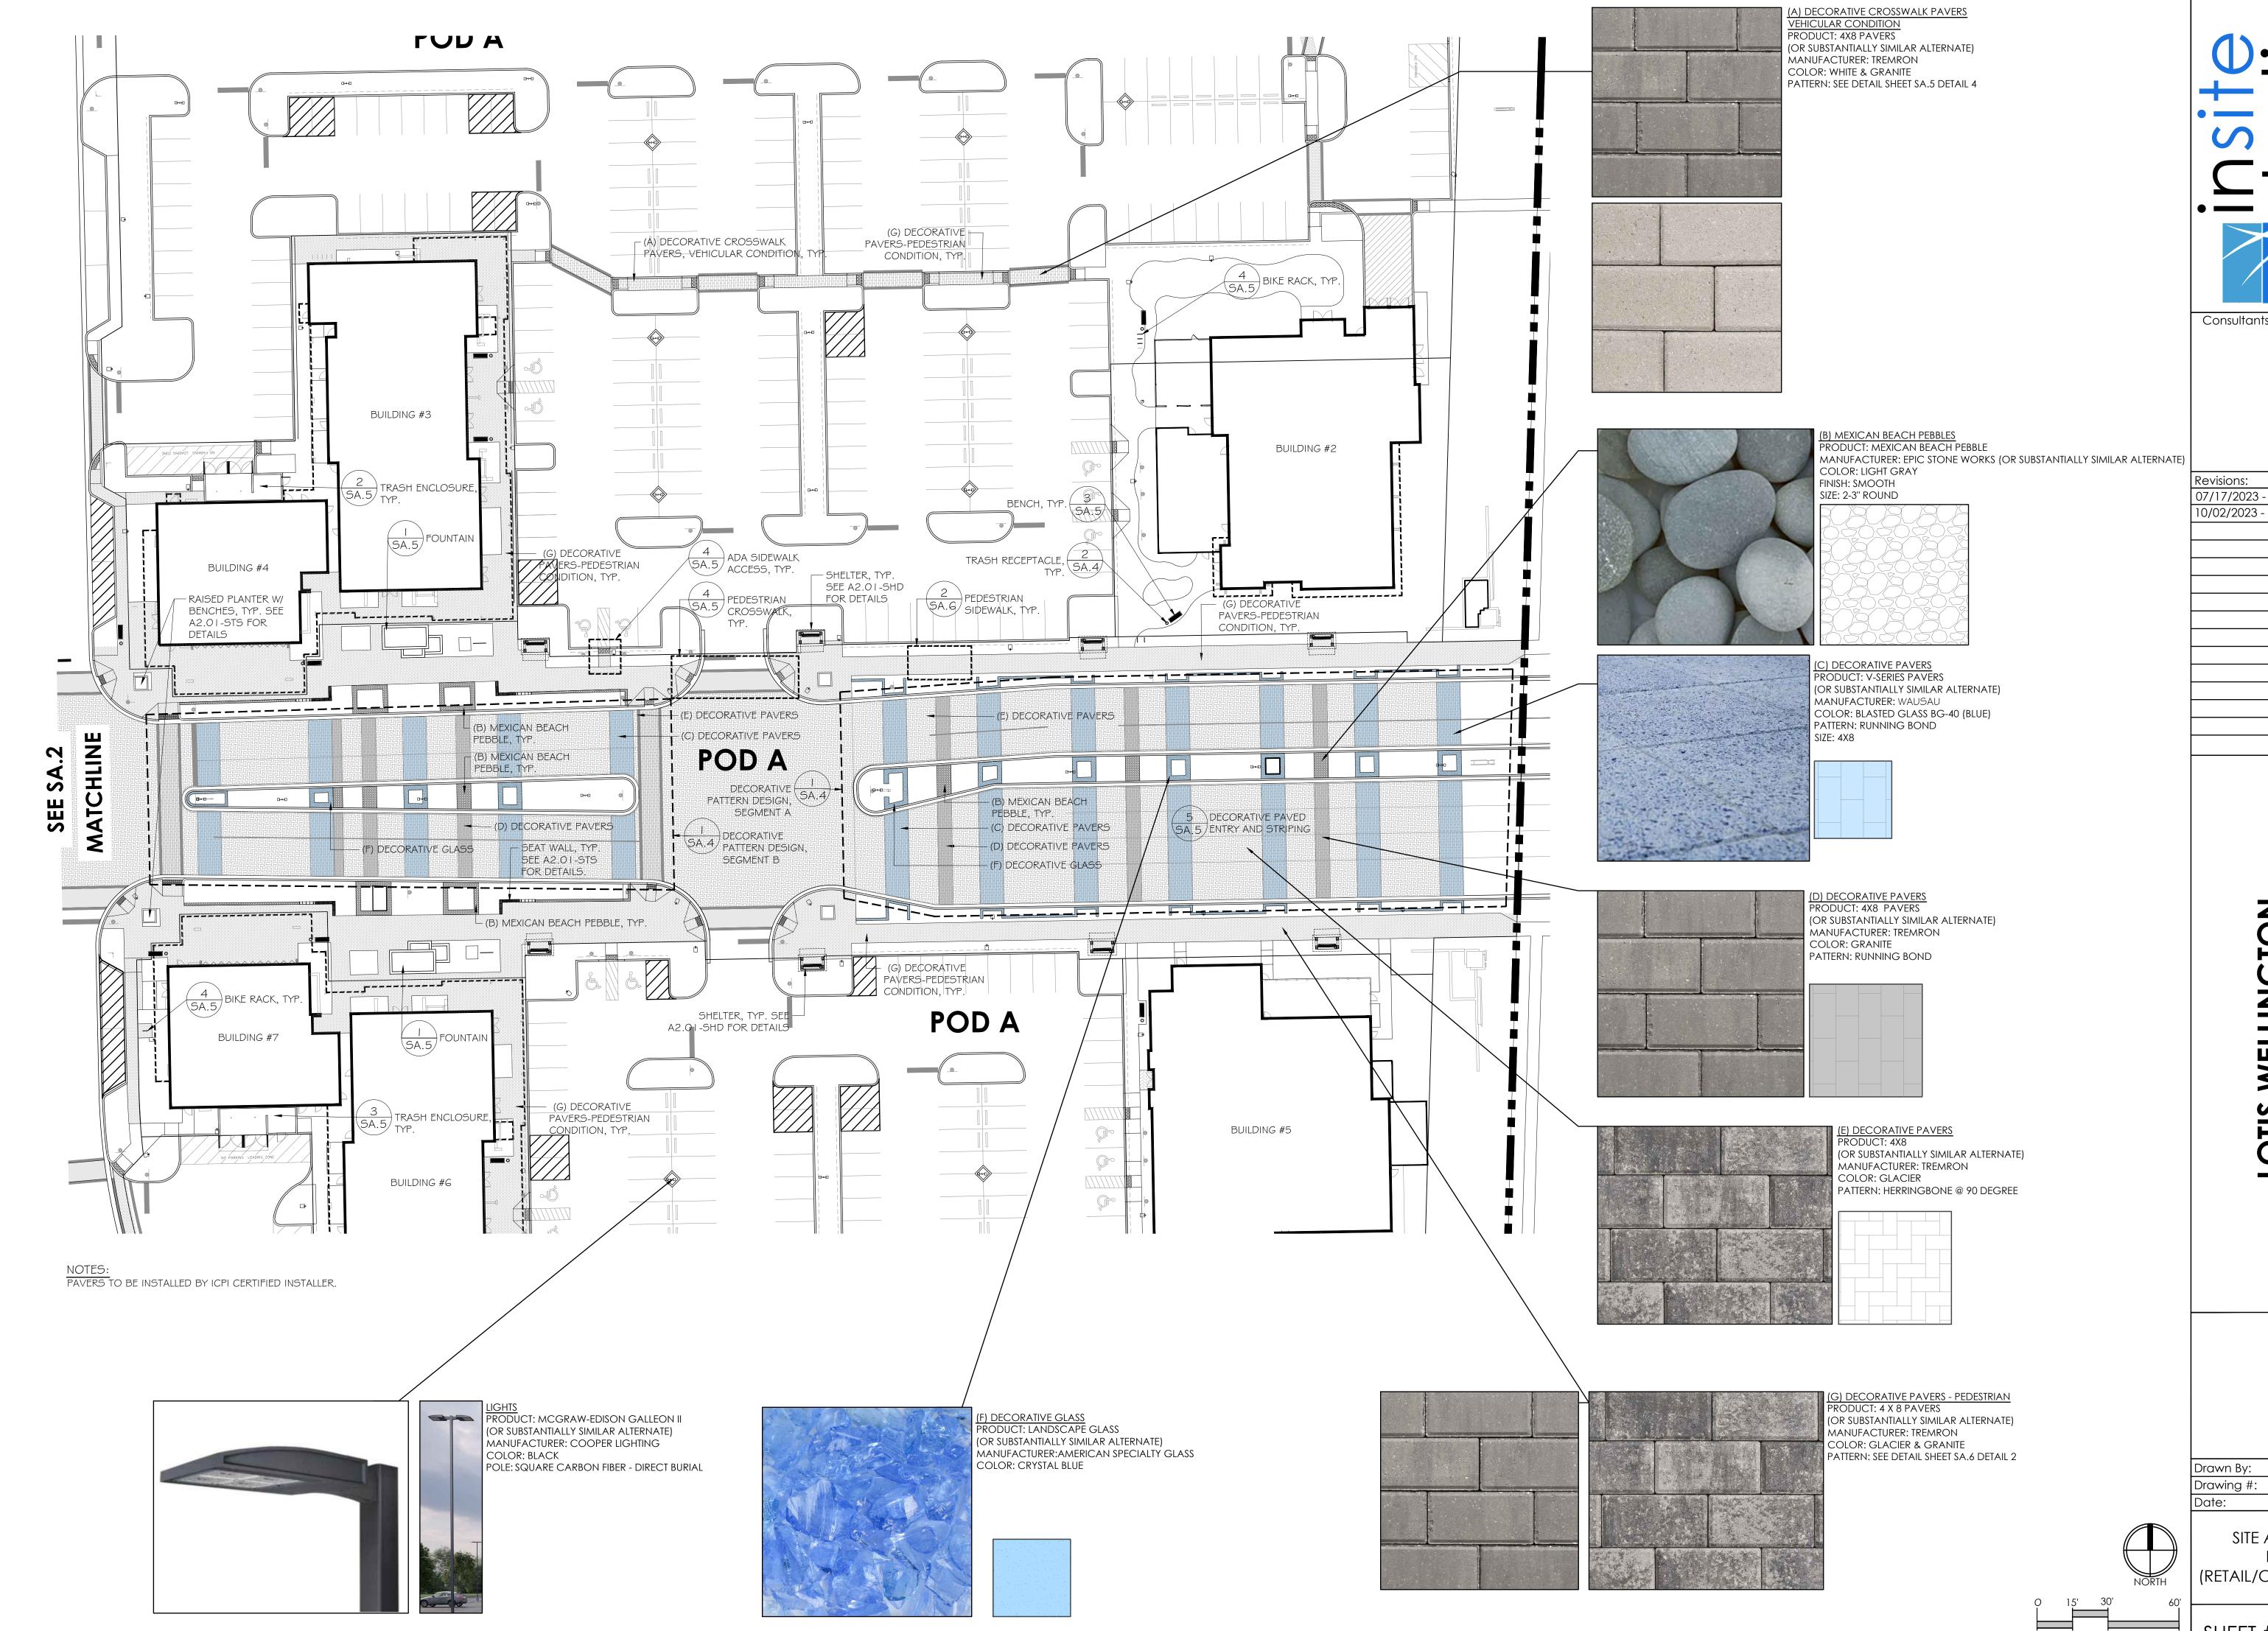

Consultants:

07/17/2023 - RESUBMITTAL

10/02/2023 - REVISION


LOTIS WELLIN Wellington,

RG 1076 01/31/2022

SITE AMENITIES PLAN (RETAIL/COMMERCIAL)

SHEET # SA.1

SCALE: 1" = 30'-0"

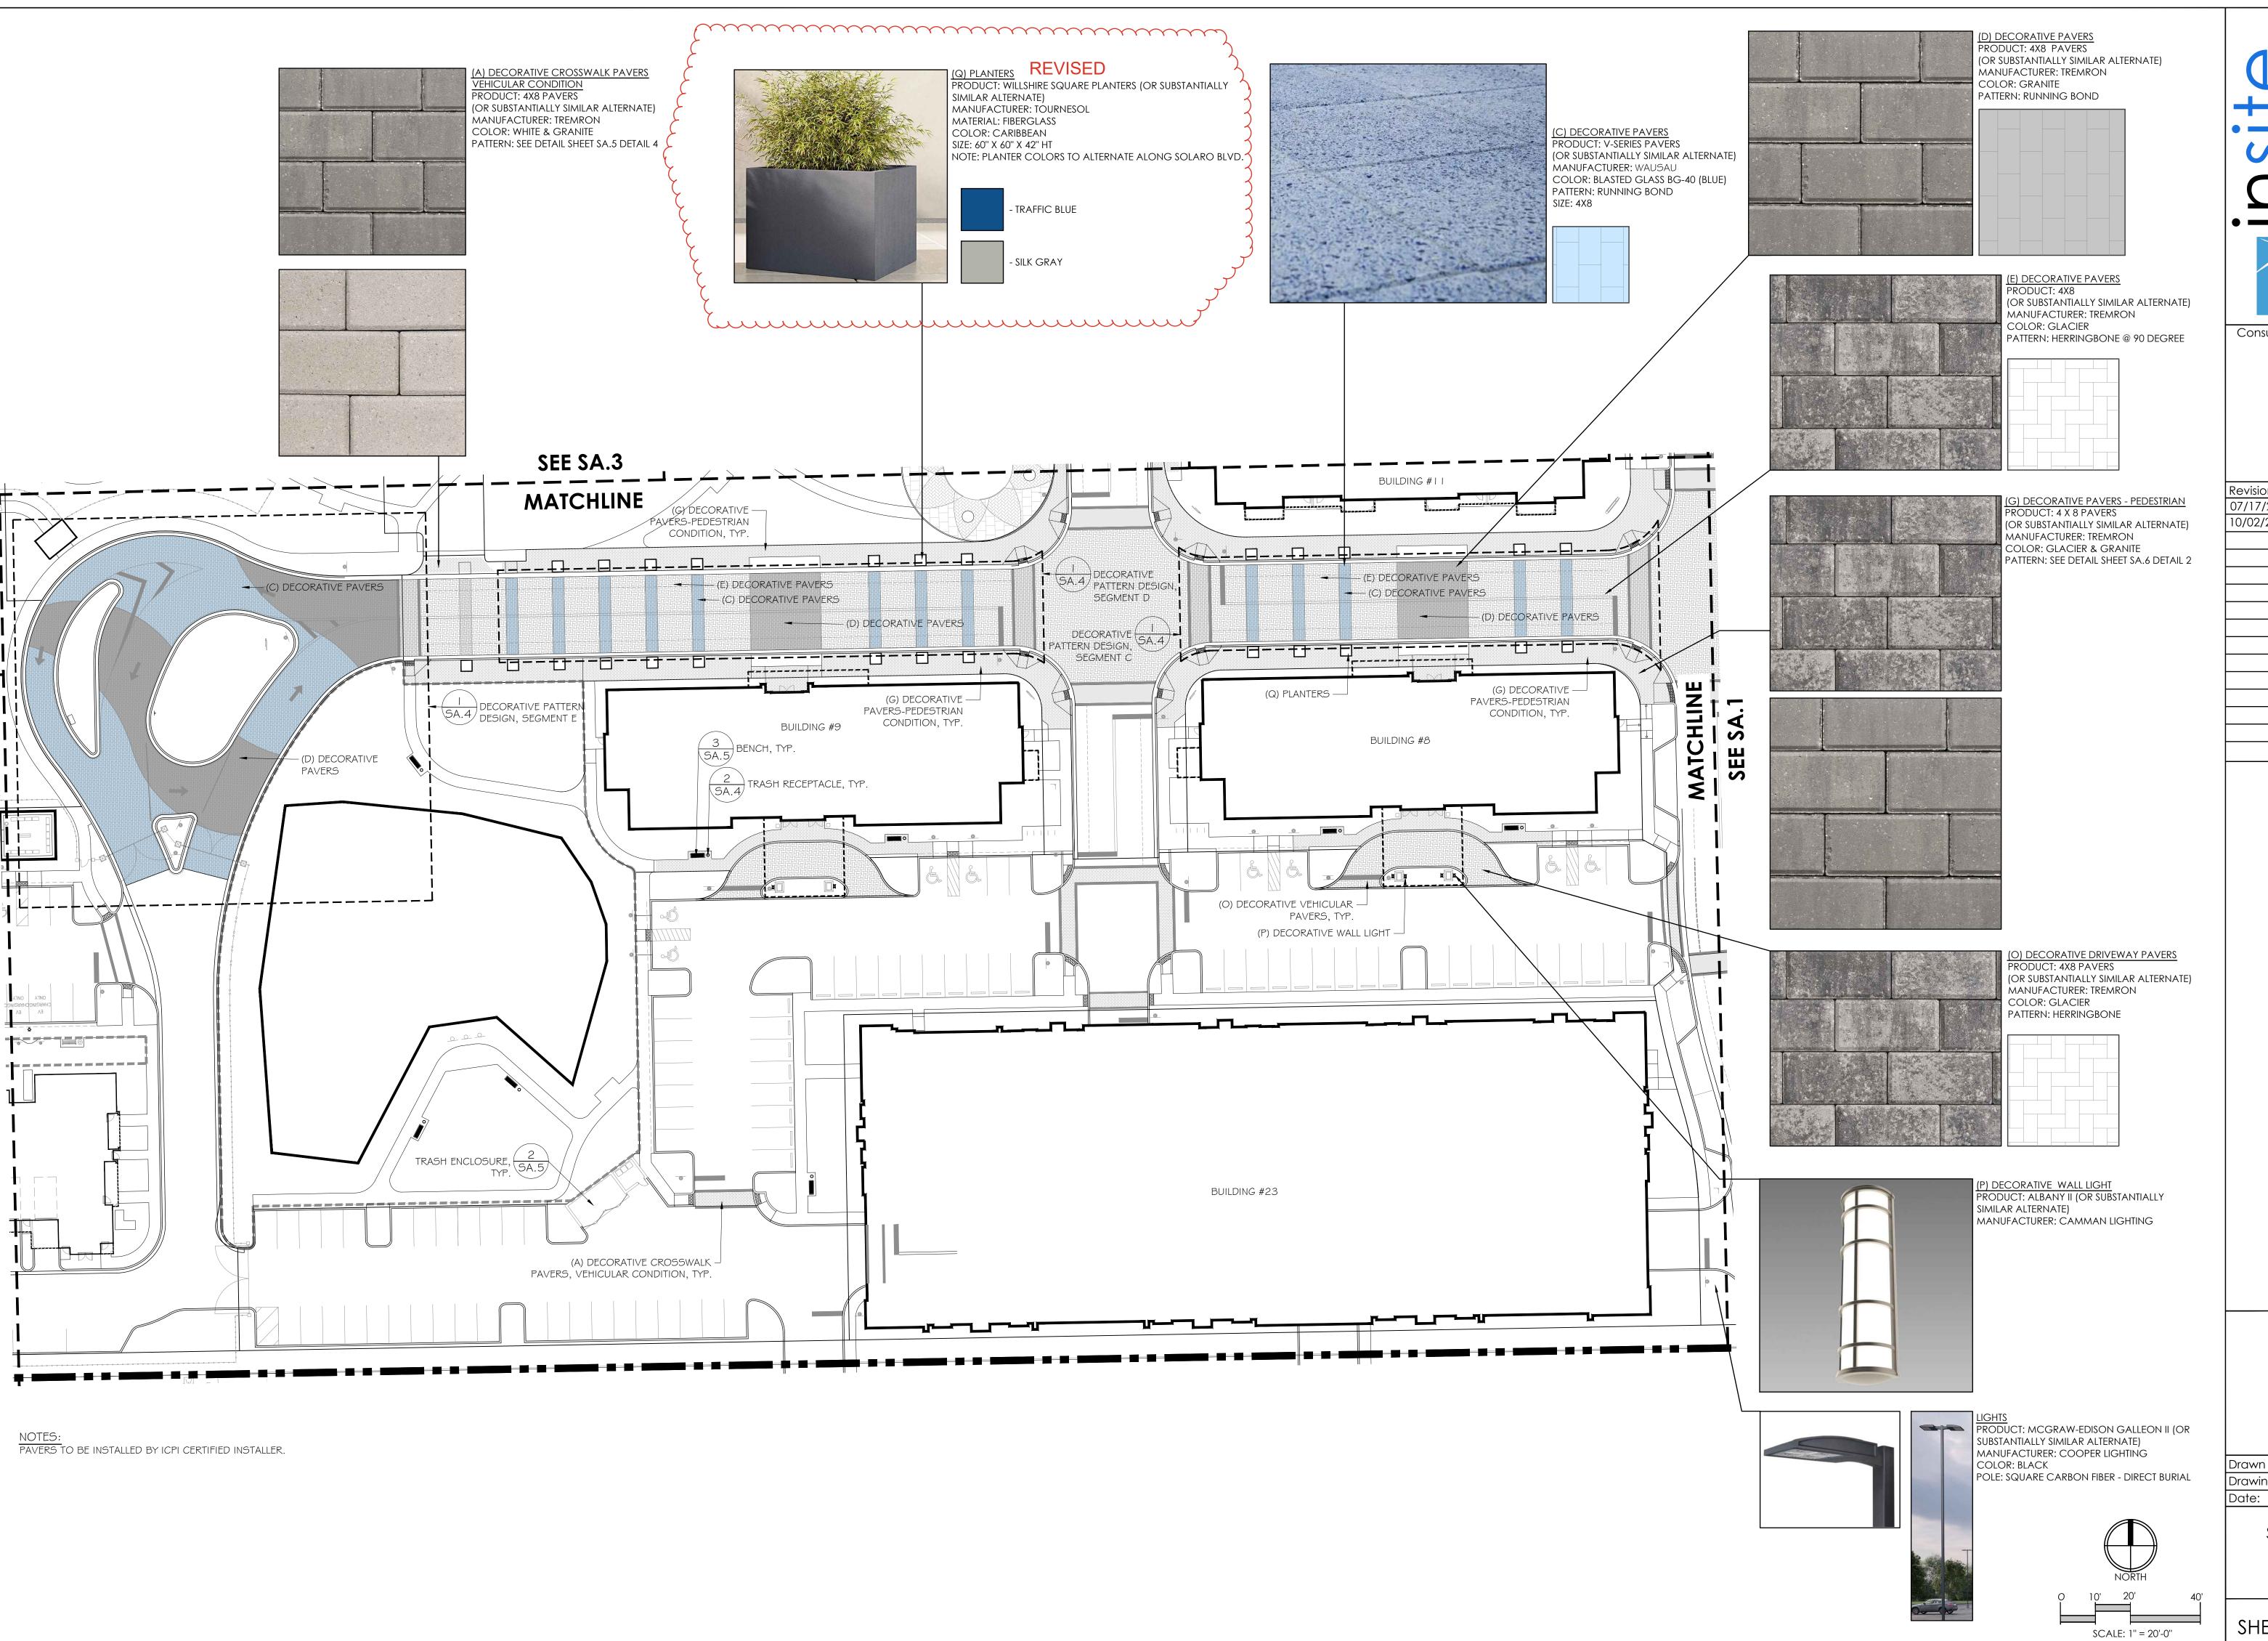

planning + landscape architecture

8144 Okeechobee Blvd. Suite A, West Palm Beach, FL 33411
phone: 561-249-0940 I email: info@insitestudio.com

Consultants:


Revisions:

07/17/2023 - RESUBMITTAL 10/02/2023 - REVISION

> LOTIS WELLINGTON Wellington, Florida

Drawn By: RG
Drawing #: 1076
Date: 01/31/2022

SITE AMENITIES PLAN (OFFICE)

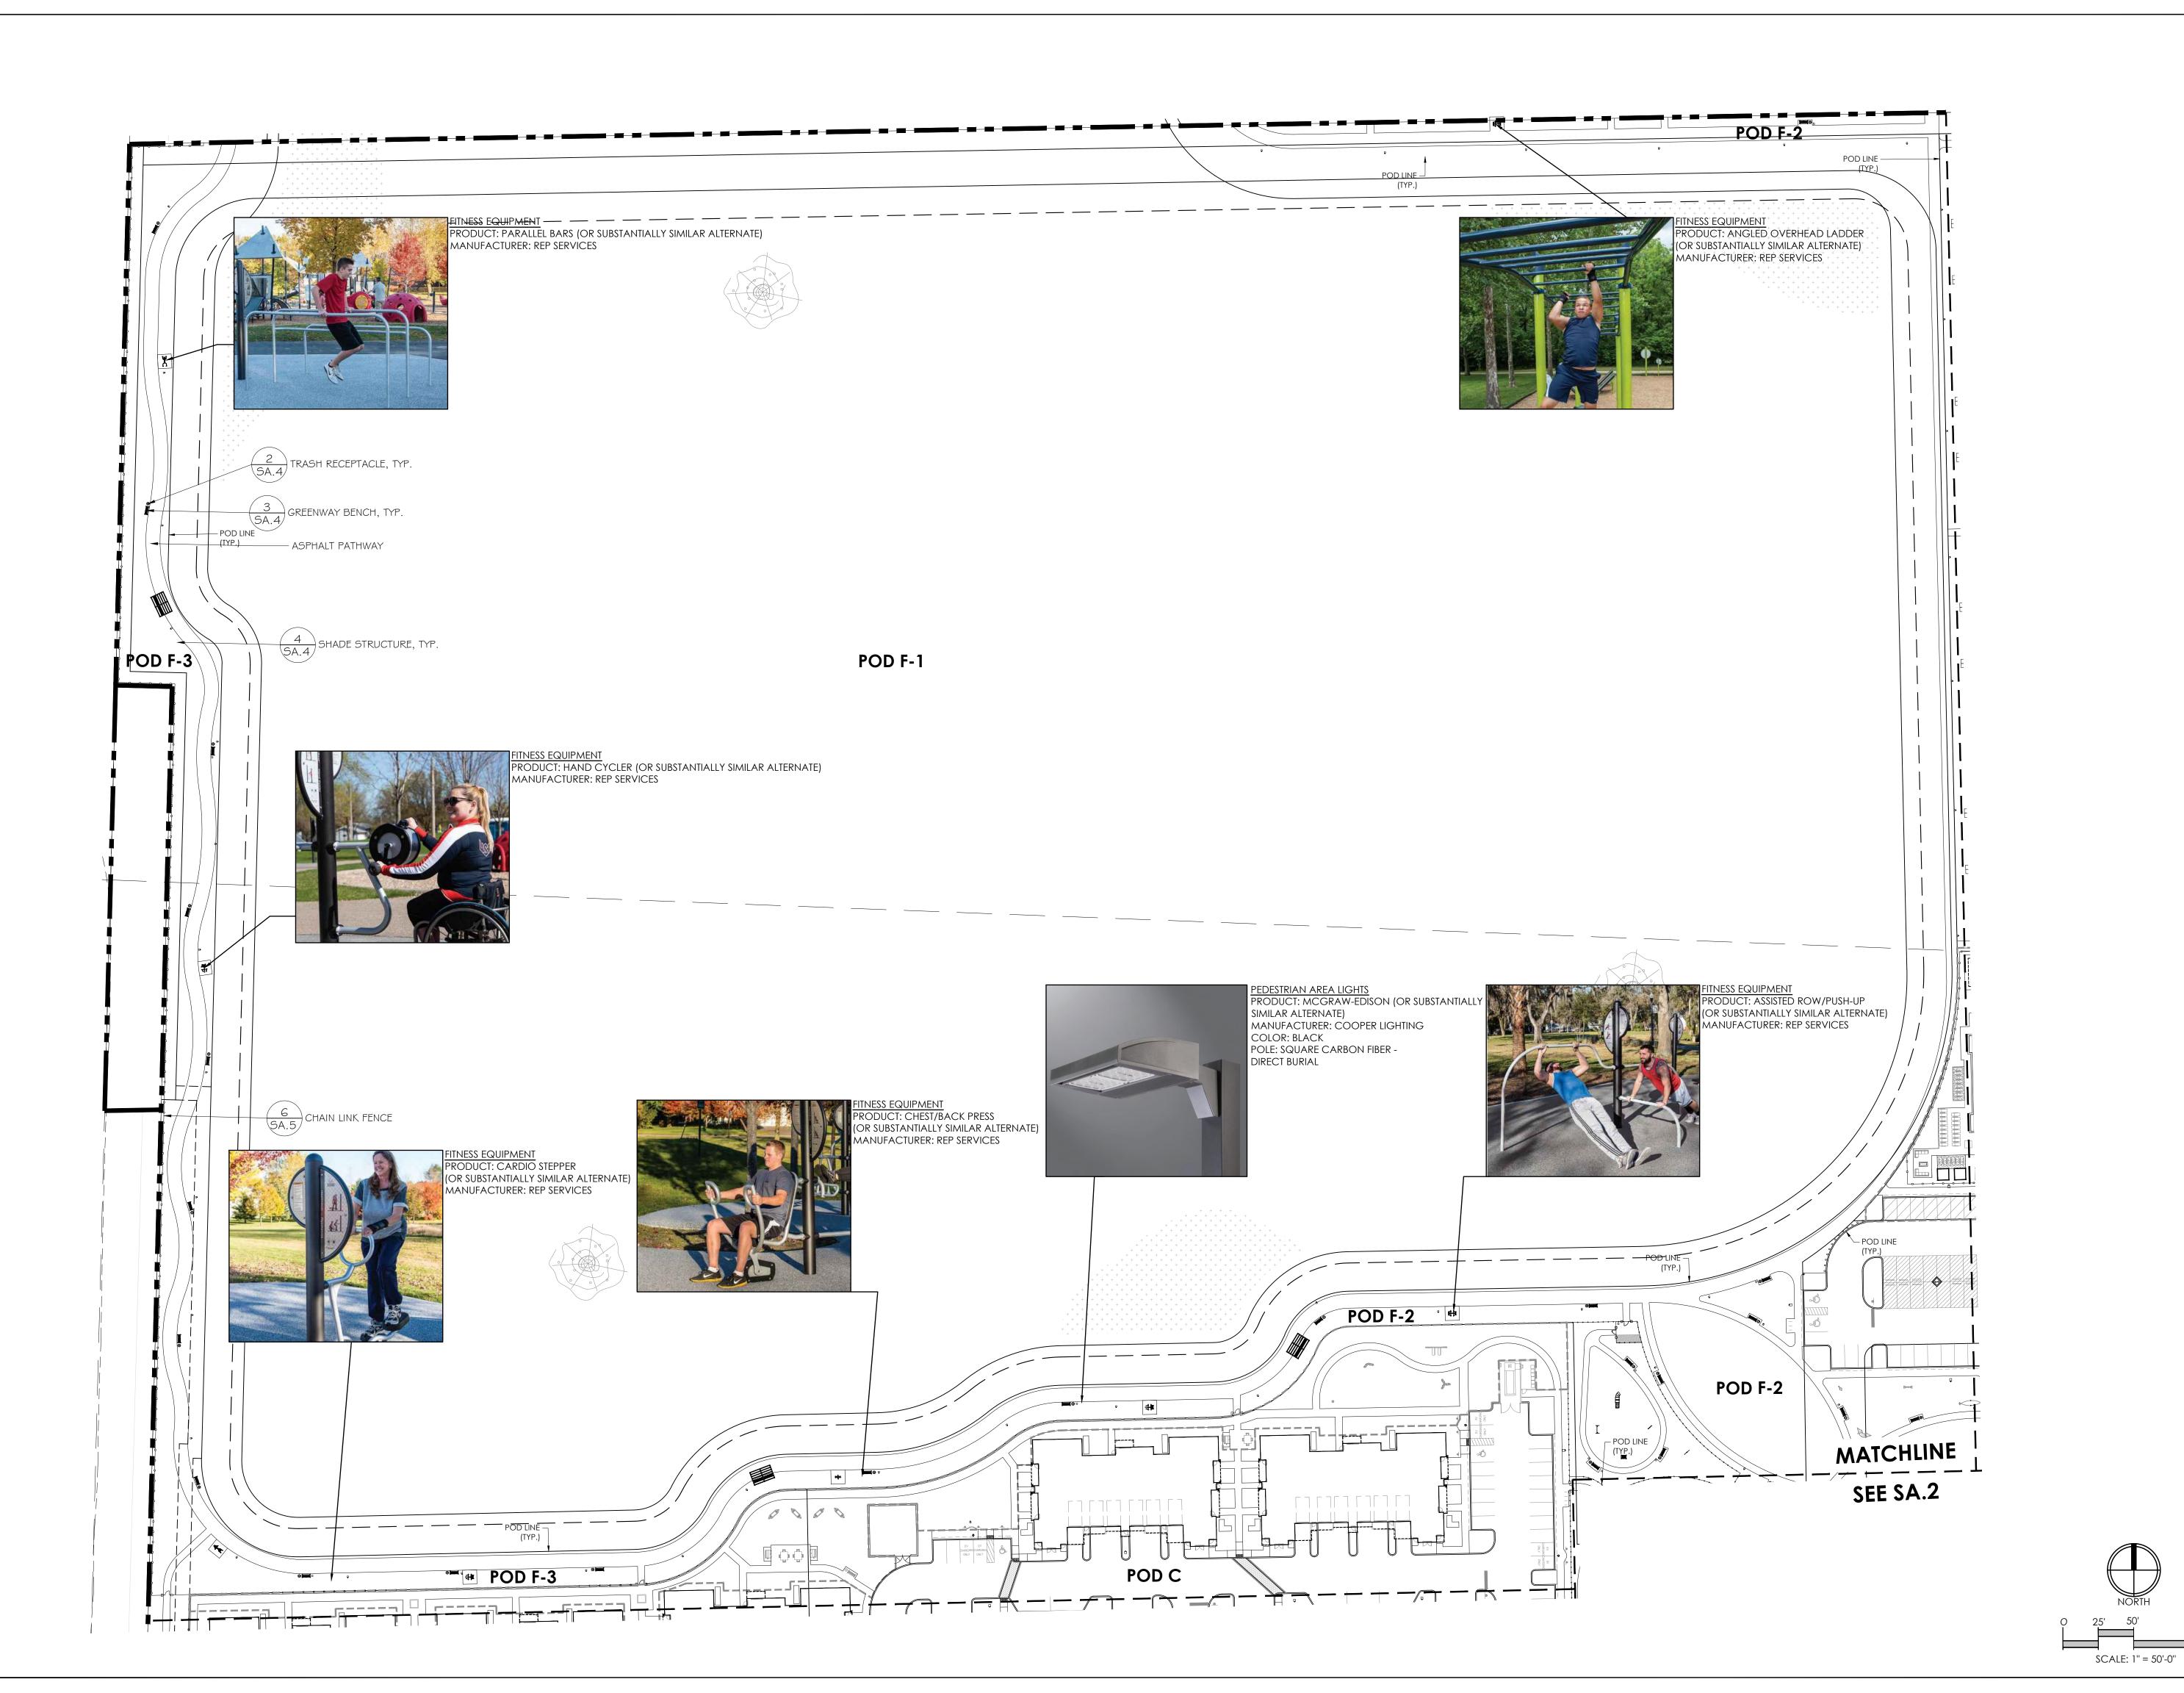





Revisions: 07/17/2023 - RESUBMITTAL 10/02/2023 - REVISION

> LOTIS WELLINGTON Wellington, Florida

Drawn By: RG
Drawing #: 1076
Date: 01/31/2022

SITE AMENITIES PLAN (GREENWAY)

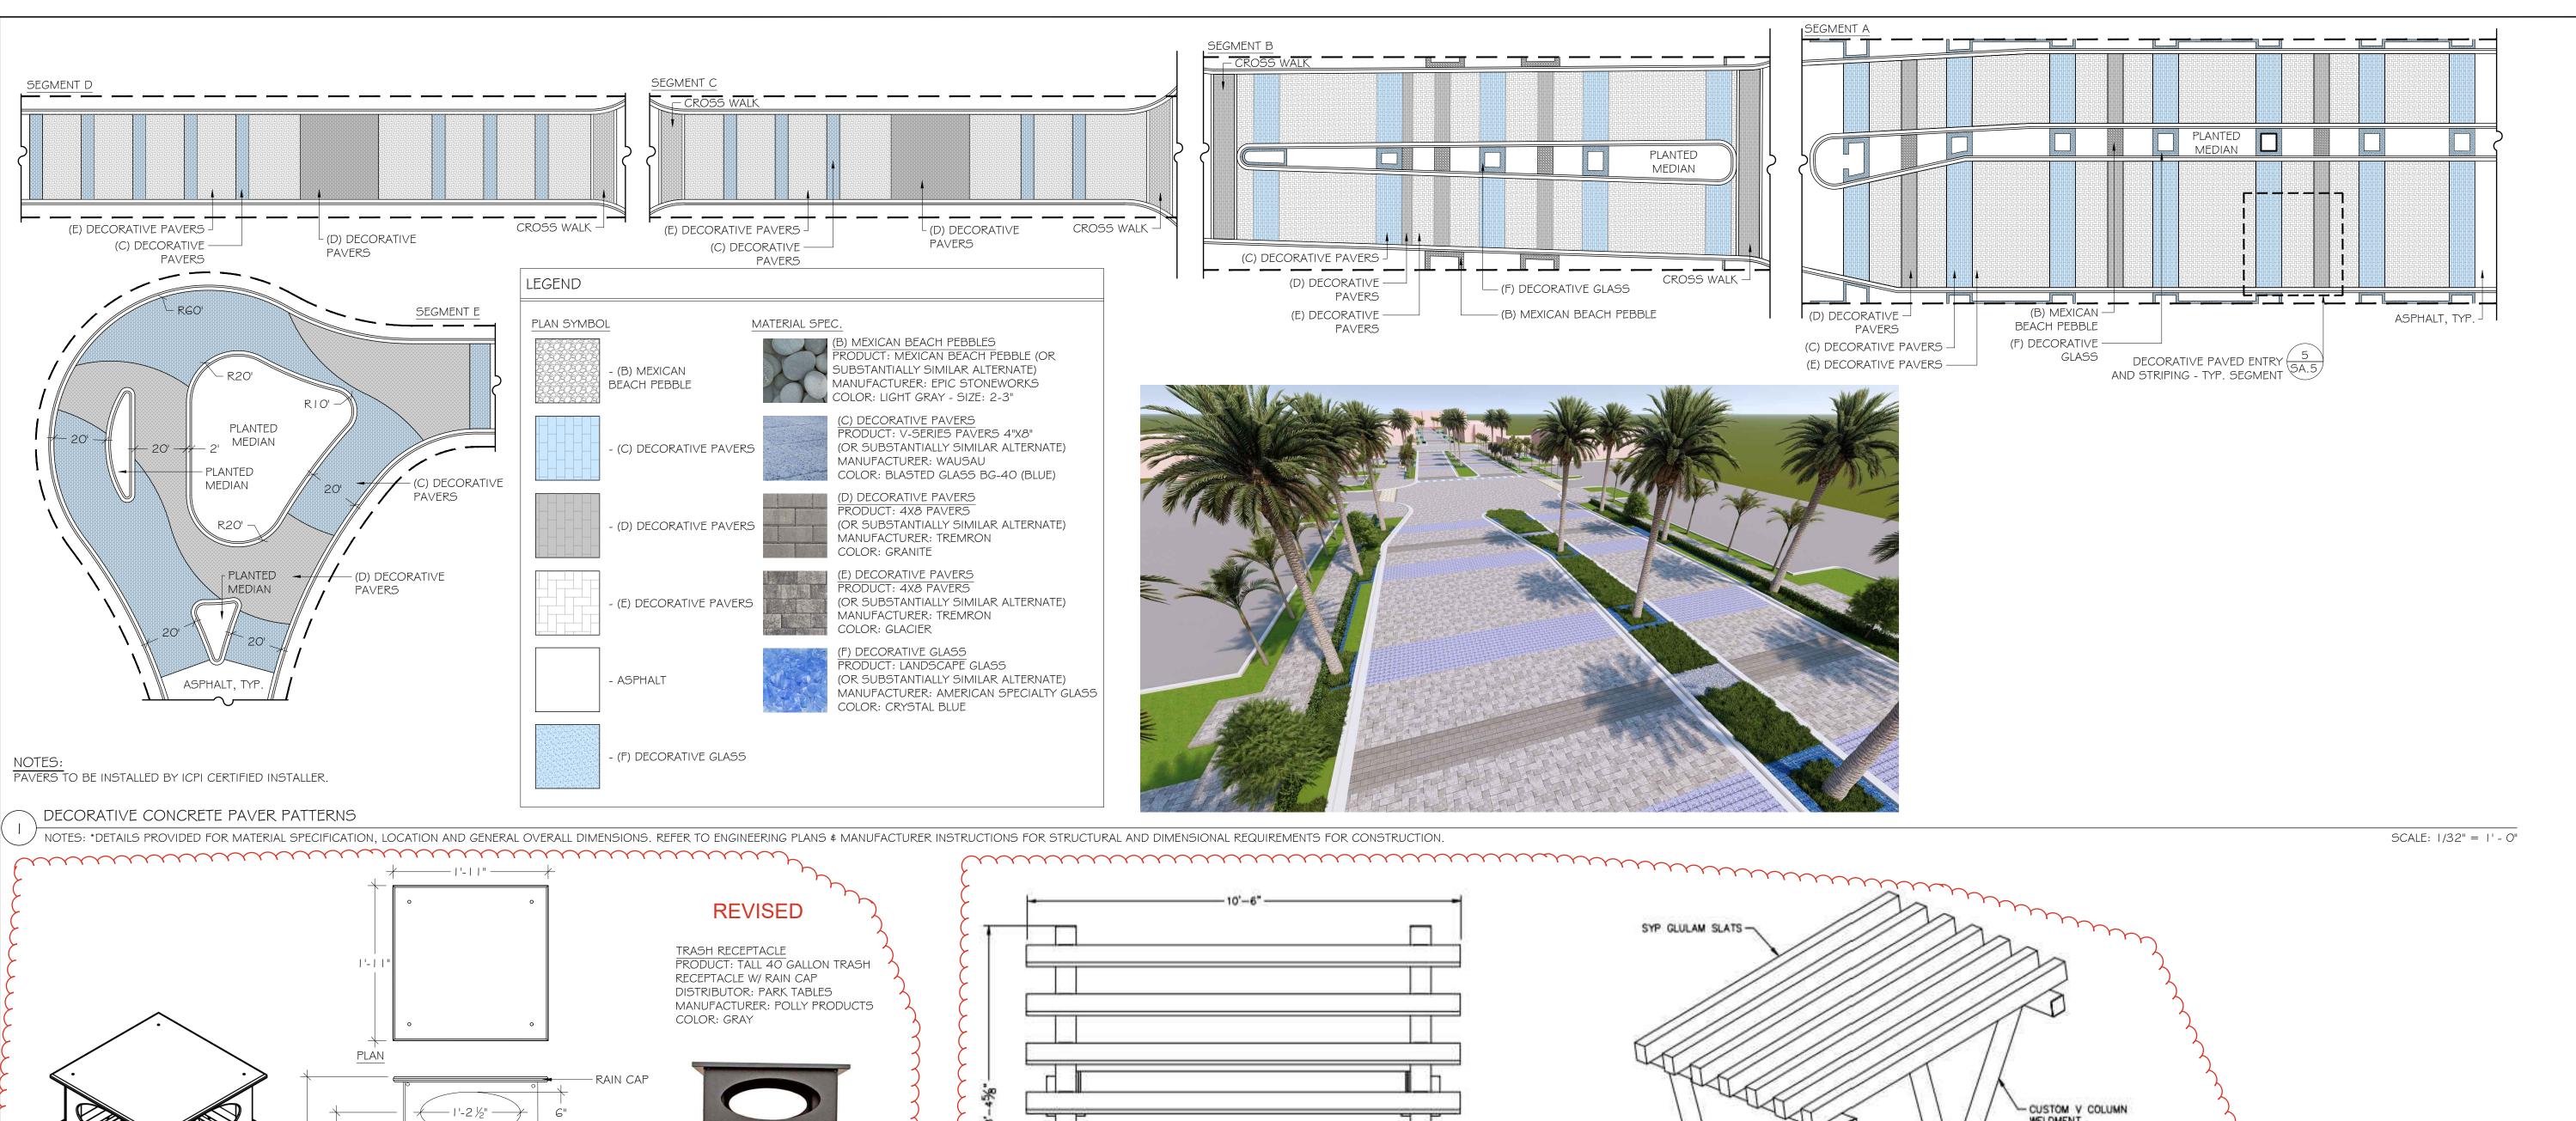

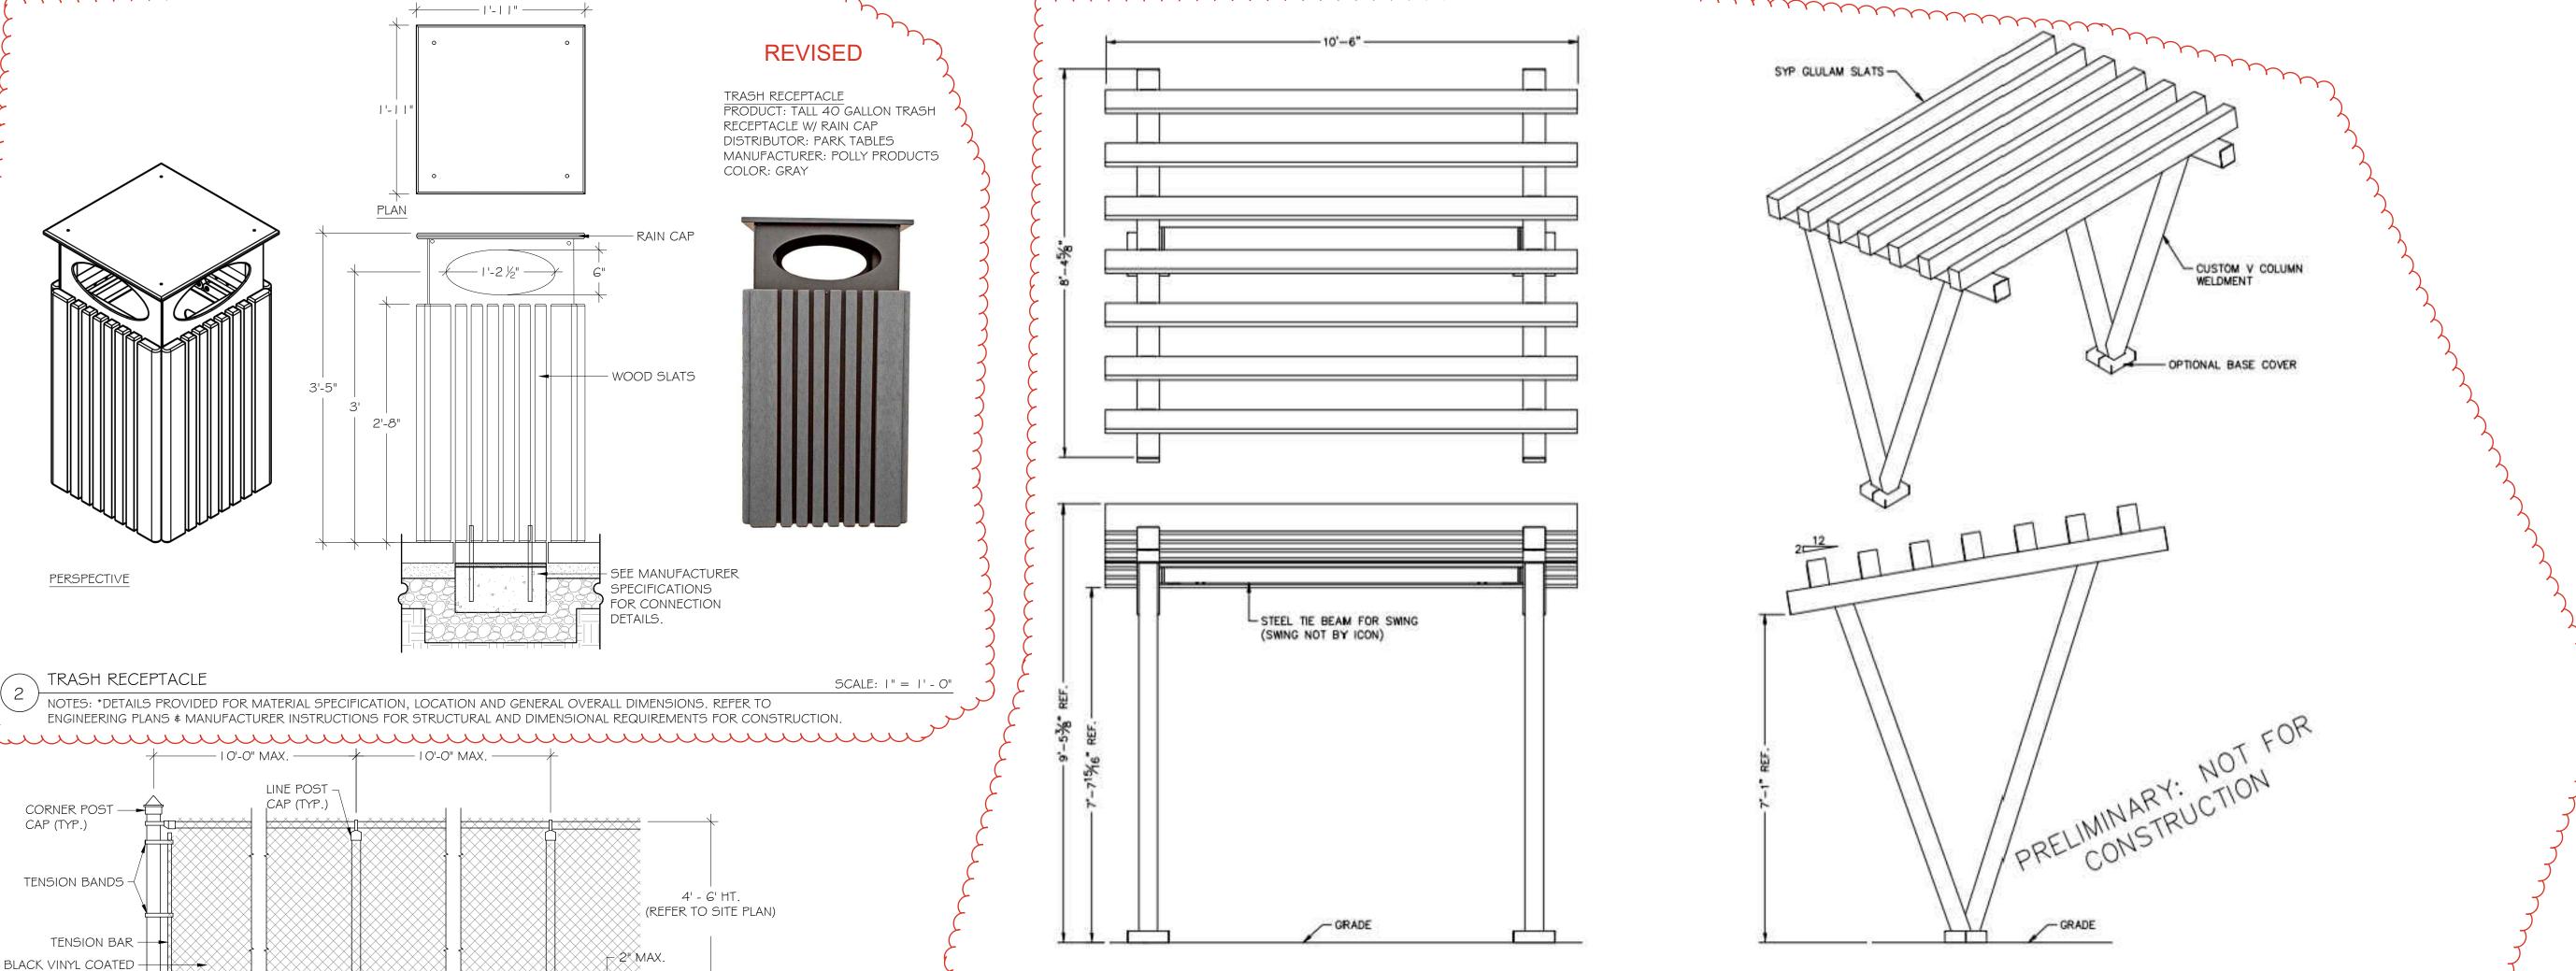

ICON SHELTERS SHADE STRUCTURE

REVISED

DETAILS PROVIDED FOR MATERIAL SPECIFICATION, LOCATION AND GENERAL OVERALL DIMENSIONS. REFER TO ENGINEERING PLANS FOR STRUCTURAL AND DIMENSIONAL REQUIREMENTS FOR CONSTRUCTION

CHAIN LINK FENCING


CHAIN LINK FENCE

REQUIREMENTS FOR CONSTRUCTION.

 $^{\prime}$  NOTES:  $^{*}$ DETAILS PROVIDED FOR MATERIAL SPECIFICATION, LOCATION AND GENERAL OVERALL DIMENSIONS.

REFER TO ENGINEERING PLANS & MANUFACTURER INSTRUCTIONS FOR STRUCTURAL AND DIMENSIONAL

SCALE: 1/2" = 1' - 0"

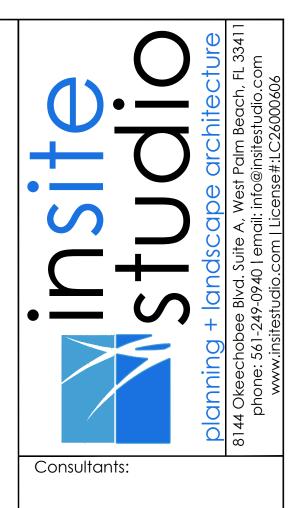

Revisions: 07/17/2023 - RESUBMITTAL 10/02/2023 - REVISION

Wellington, Florida

 Drawn By:
 RG


 Drawing #:
 1076

 Date:
 01/31/2022

SITE AMENITIES DETAILS

SHEET # SA.4

SCALE: 1/2" = 1'- 0"

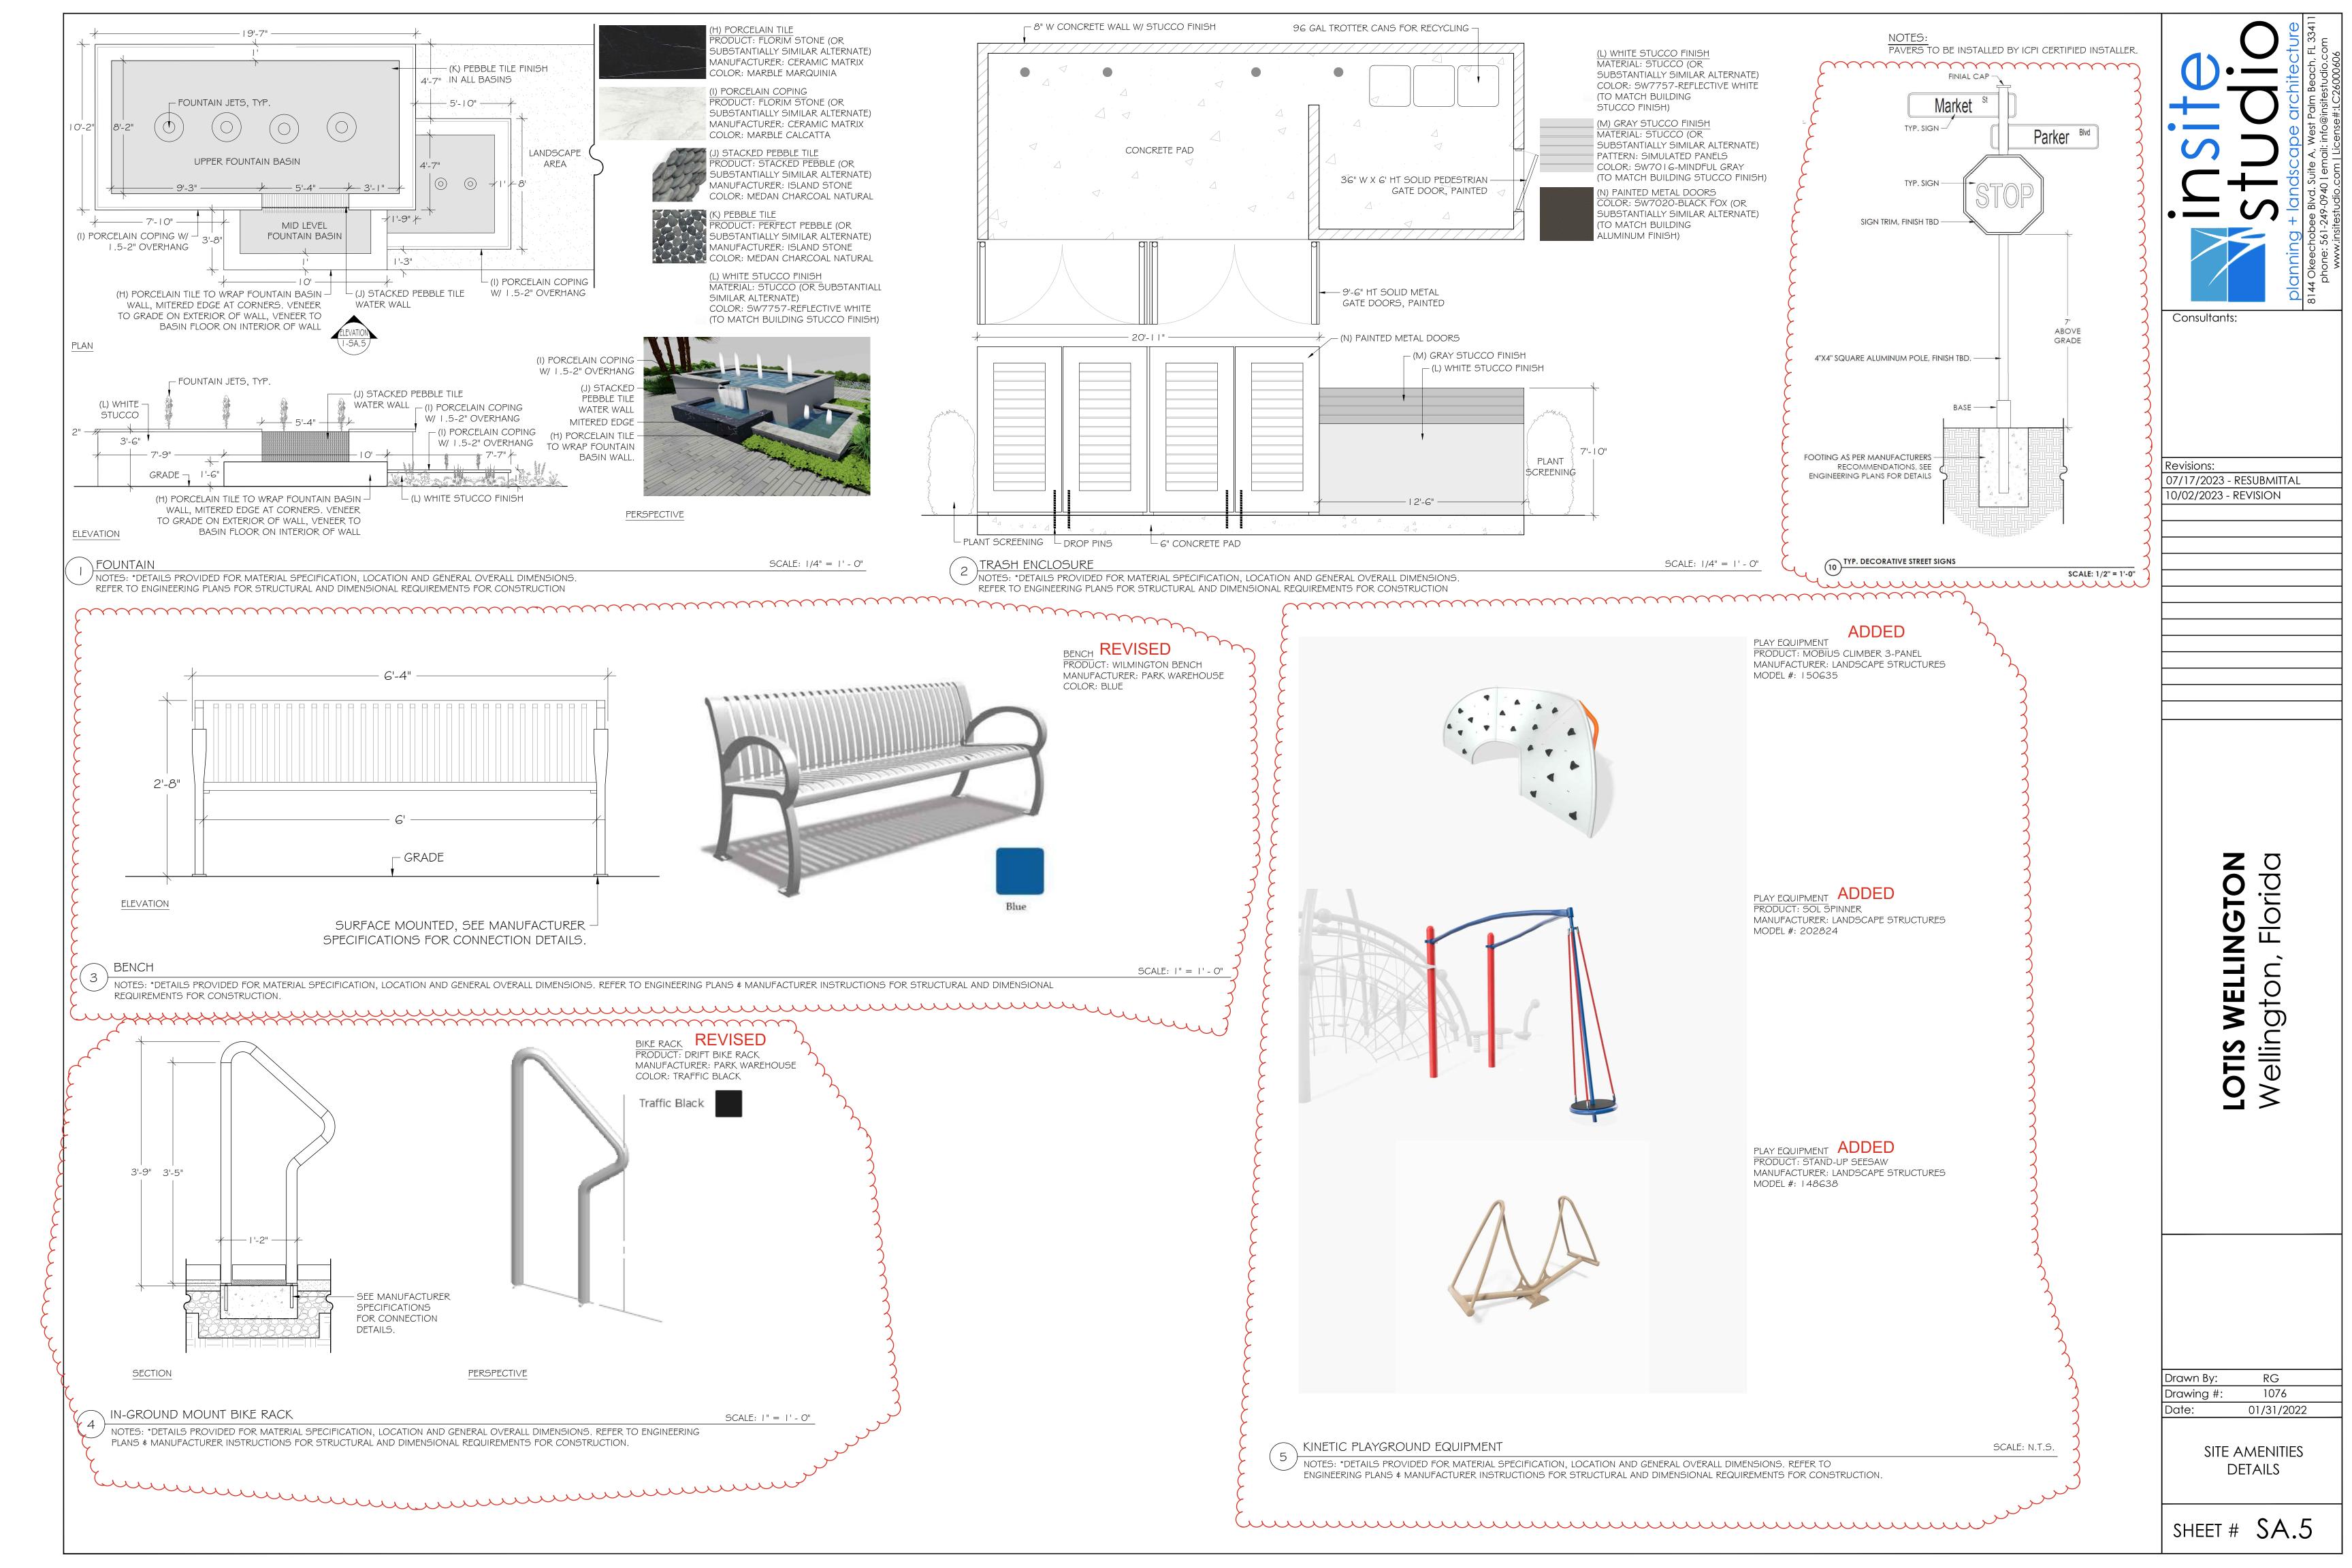

# **BOW WOW KIT** (6 pieces) **TUNNEL RUN** CANINE CONDO TUG AROUND



PET DRINKING FOUNTAIN

HOOP JUMP

## DOG WASH STATION

MAIN BODY: 50" W x 58" H x 27" D

MATERIAL: 16 gauge 304 stainless steel

- Removable Adjustable Overhead Arm - Stainless Steel Backsplash - Tub Faucet and Sprayer kit - Temporary drain kit w/ flexible hose - Stainless Steel Shampoo Rack - Two-piece, removable floor grate

FINISH: Stainless Steel

#### ADDED

DOG PARK EQUIPMENT

HERCULES INCORPORATED SIZE: 50" W. X 58" HT. X 27" D.

MANUFACTURER:

PRODUCT: DOG WASH STATION

DOG PARK EQUIPMENT PRODUCT: DOG FOUNTAIN, SINGLE SPOUT MANUFACTURER: HERCULES INCORPORATED SIZE: 22.5" L X | 3" W. X 32" HT. COLOR: BLUE

DOG PARK EQUIPMENT PRODUCT: 32 GAL TRASH RECEPTACLE MANUFACTURER: HERCULES INCORPORATED COLOR: BLUE



DOG PARK EQUIPMENT PRODUCT: 6 FT. BENCH MANUFACTURER: HERCULES INCORPORATED COLOR: BLUE



32 GAL. TRASH RECEPTACLE

OVERALL DIMENSION: 72" Length, 18" Seat Height (after install), 30.5" Overall Height, 10" Seat Width SEAT MATERIAL: Expanded Metal


SEAT COATING: Premium Polyethylene Coating

FRAME MOUNT: Inground Mount

6' PARK BENCH W/ BACK

FRAME COATING: Highly Durable Architectural Grade electrostatic applied Powder Coat

HARDWARE: All hardware is Xylan coated black hardware for extra protection and strength

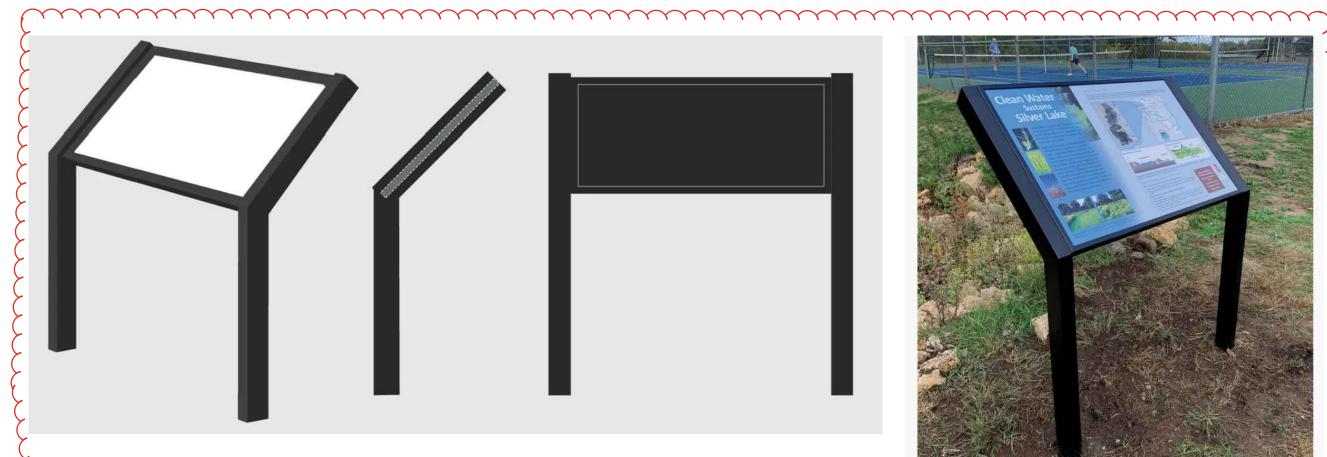



COLOR: BLACK

SIZE: 24" X 36" Revisions: 07/17/2023 - RESUBMITTAL

Consultants:

10/02/2023 - REVISION

SCALE: |" = |-0"

- SIGN FRAME - IN GROUND MOUNTED POSTS (2) - SEE MANUFACTURER SPECIFICATIONS FOR CONNECTION DETAILS.

DETAILS PROVIDED FOR MATERIAL SPECIFICATION, LOCATION AND GENERAL OVERALL DIMENSIONS. REFER TO ENGINEERING PLANS FOR STRUCTURAL AND DIMENSIONAL REQUIREMENTS FOR CONSTRUCTION

The manuel the state of the sta

COLOR: BLUE

DECORATIVE PEDESTRIAN PAVERS

MANUFACTURER: HERCULES INCORPORATED

PET WASTE STATION

DOG PARK EQUIPMENT

PRODUCT: THE BOW WOW KIT

NOTES: \*DETAILS PROVIDED FOR MATERIAL SPECIFICATION, LOCATION AND GENERAL OVERALL DIMENSIONS. REFER TO ENGINEERING PLANS & MANUFACTURER INSTRUCTIONS FOR STRUCTURAL AND DIMENSIONAL REQUIREMENTS FOR CONSTRUCTION.

ADJUSTABLE JUMP

SCALE: N.T.S.

VIEWING SIGNS

Wellington,

Drawn By:	RG
Drawing #:	1076
Date:	01/31/2022

SITE AMENITIES DETAILS



(A) DECORATIVE CROSSWALK PAVERS - VEHICULAR CONDITION 4 X 8 TREMRON PAVERS COLOR: GRANITE DECORATIVE CROSSWALK PAVERS - VEHICULAR CONDITION 4 X 8 TREMRON PAVERS COLOR: WHITE <del>/</del> 2' <del>/</del> 4' O.C. - DETECTABLE WARNING PAVERS 4 X 8 TREMRON PAVERS COLOR: CHARCOAL

\ DECORATIVE PAVERS (VEHICULAR CONDITION) - PATTERN DETAIL

SIDEWALK

ENGINEERING PLANS FOR STRUCTURAL AND DIMENSIONAL REQUIREMENTS FOR CONSTRUCTION

NOTES: \*DETAILS PROVIDED FOR MATERIAL SPECIFICATION, LOCATION AND GENERAL OVERALL DIMENSIONS. REFER TO

NOTES: \*DETAILS PROVIDED FOR MATERIAL SPECIFICATION, LOCATION AND GENERAL OVERALL DIMENSIONS. REFER TO ENGINEERING PLANS \$

MANUFACTURER INSTRUCTIONS FOR STRUCTURAL AND DIMENSIONAL REQUIREMENTS FOR CONSTRUCTION.

SCALE: 1/2" = 1' - 0"

PEDESTRIAN CROSSWALK NOTES: \*DETAILS PROVIDED FOR MATERIAL SPECIFICATION, LOCATION AND GENERAL OVERALL DIMENSIONS. REFER TO ENGINEERING PLANS \$

MANUFACTURER INSTRUCTIONS FOR STRUCTURAL AND DIMENSIONAL REQUIREMENTS FOR CONSTRUCTION.

SCALE: 1/2" = 1' - 0"

LANDSCAPE AREA (G) DECORATIVE PAVERS - PEDESTRIAN CONDITION 4 X 8 TREMRON PAVER BANDING PATTERN: SOLDIER COURSE COLOR: LIGHT HUNTINGTON 4 X 8 TREMRON PAVERS PATTERN: HERRINGBONE PATTERN COLOR: GLACIER (G) DECORATIVE PAVERS - PEDESTRIAN CONDITION 4 X 8 TREMRON PAVERS PATTERN: RUNNINGBOND COLOR: GRANITE LANDSCAPE AREA

- (D) 4X 8 PAVERS BY TREMRON AS LANE STRIPING AND STOP BARS, VEHICULAR CONDITIONS. COLOR: YELLOW

> — (F) CONCRETE CURB AND **GUTTER**

> > - LANDSCAPE AREA

- (D) 4X8 PAVERS BY

CONDITIONS.

CONDITIONS. COLOR: GLACIER

CONDITIONS.

COLOR: BLUE

COLOR: GRANITE

- (E) 4X8 PAVERS BY TREMRON, VEHICULAR

- (C) 4X8 V-SERIES PAVERS

BY WAUSAU, VEHICULAR

TREMRON, VEHICULAR

DECORATIVE PAVED ENTRY AND STRIPING - TYP. SEGMENT NOTES: \*DETAILS PROVIDED FOR MATERIAL SPECIFICATION, LOCATION AND GENERAL OVERALL DIMENSIONS.


Drawn By: Drawing #:

Consultants:

Revisions:

07/17/2023 - RESUBMITTAL 10/02/2023 - REVISION

PAVERS TO BE INSTALLED BY ICPI CERTIFIED INSTALLER.

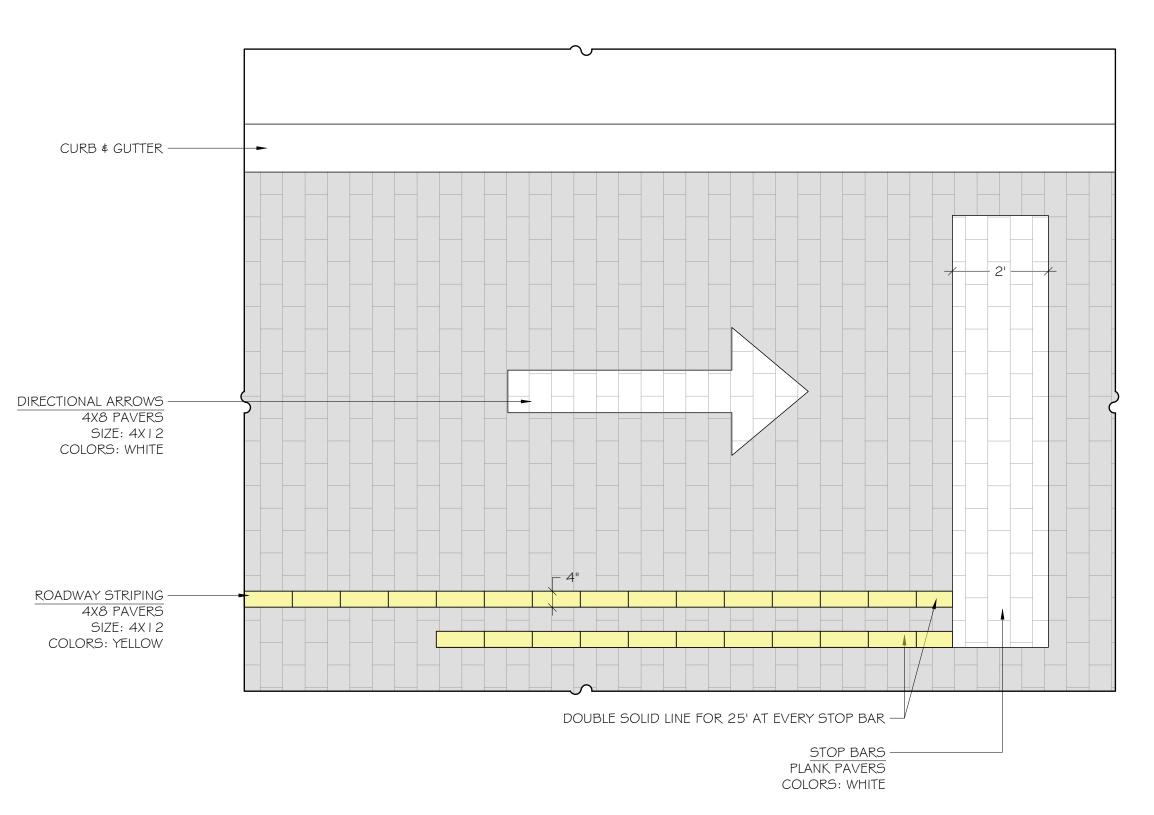

(G) DECORATIVE PAVERS - PEDESTRIAN CONDITION

SCALE: 1/2" = 1' - 0"

REFER TO ENGINEERING PLANS FOR STRUCTURAL AND DIMENSIONAL REQUIREMENTS FOR CONSTRUCTION

SCALE: 1/4" = 1' - 0"

SITE AMENITIES DETAILS

RG

1076

01/31/2022